



WEST ELEVATION





SOUTH ELEVATION




EAST ELEVATION




NORTH ELEVATION

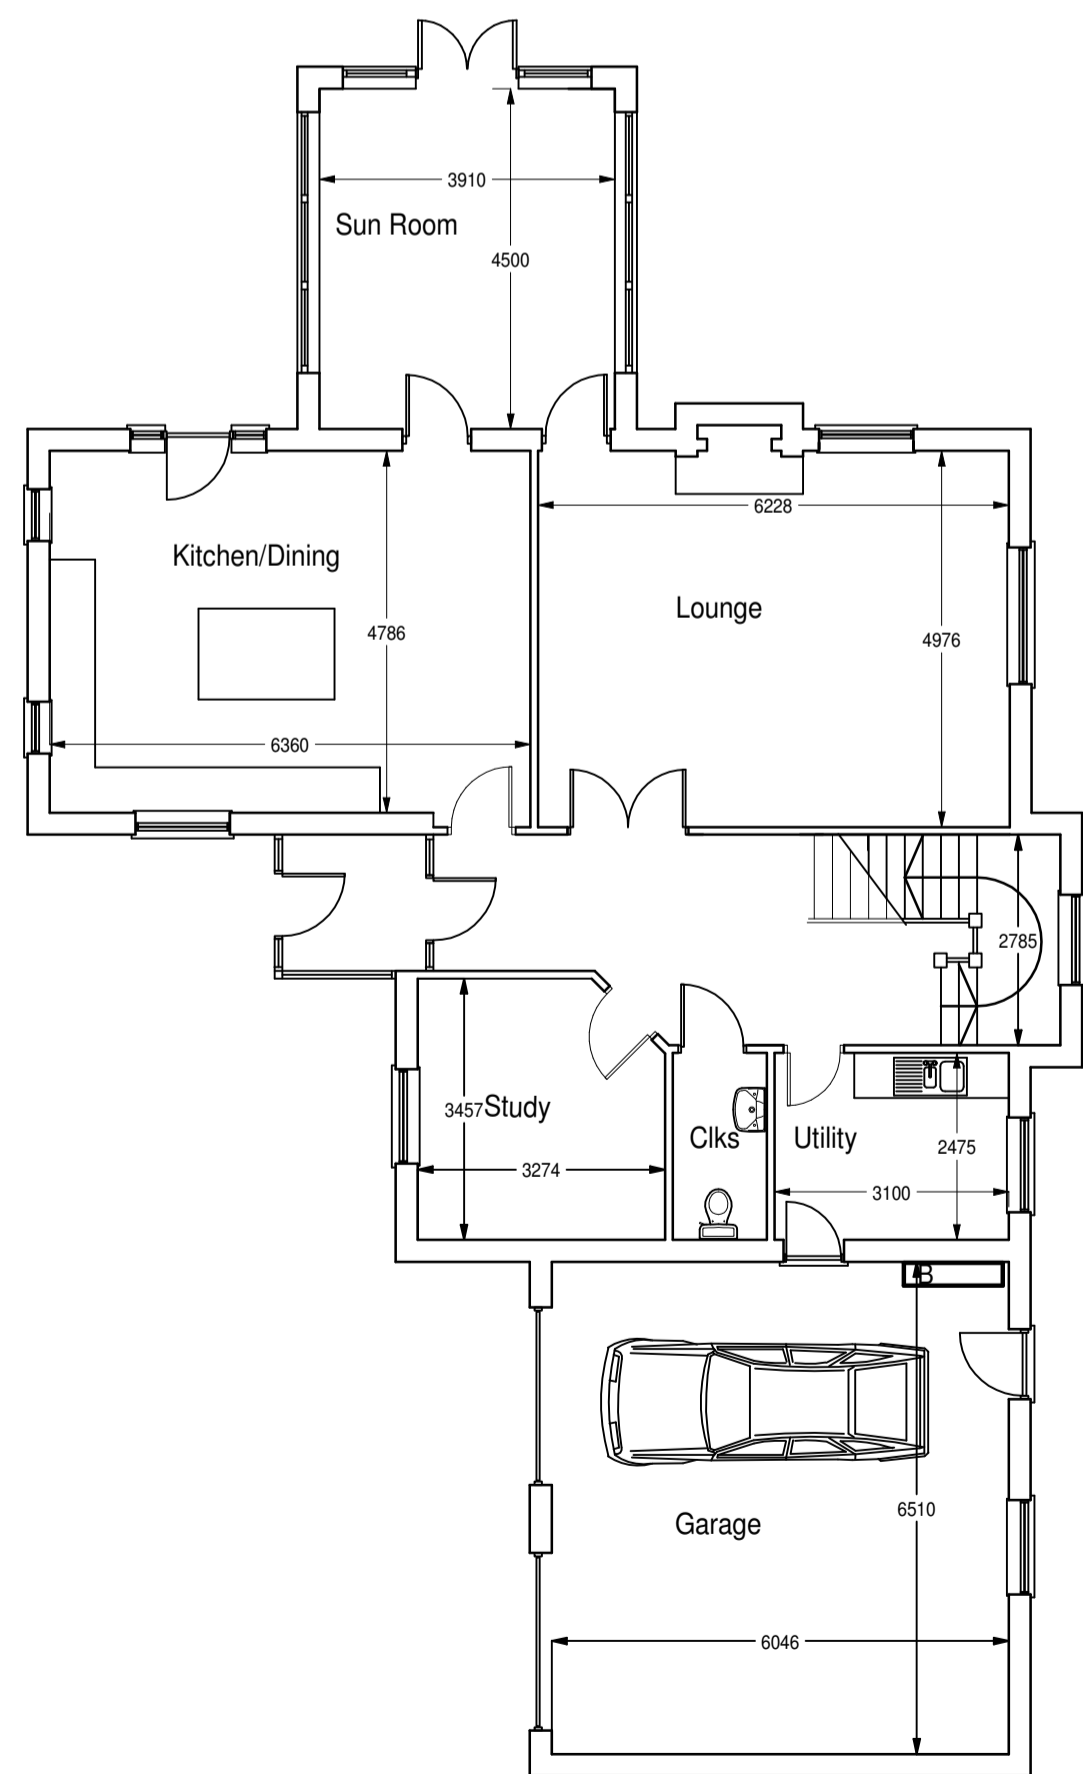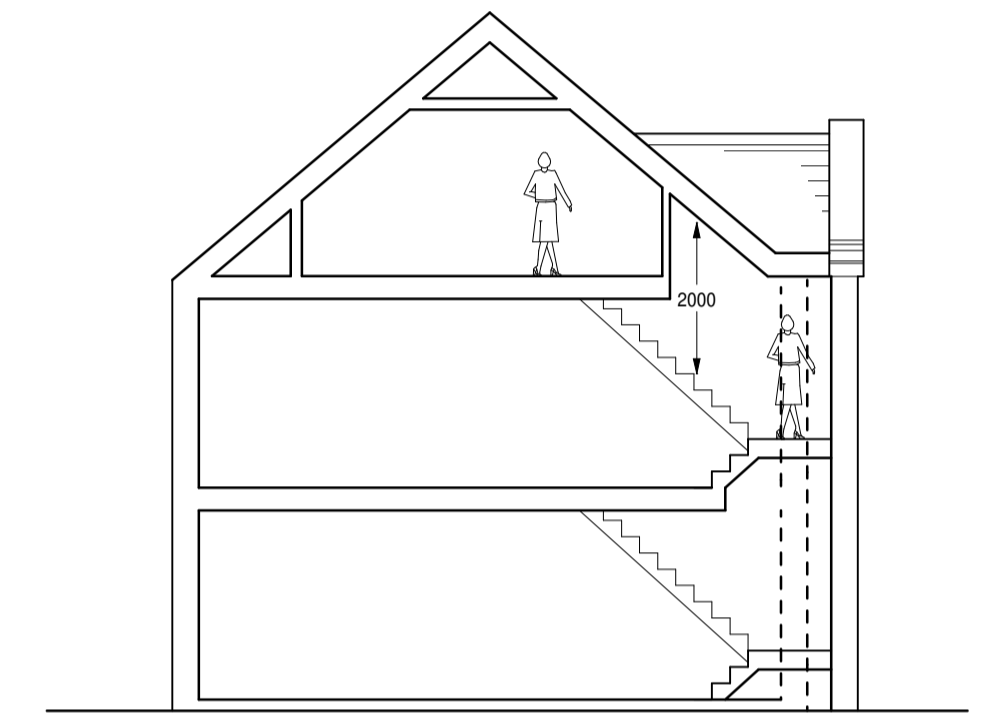

GROUND FLOOR PLAN

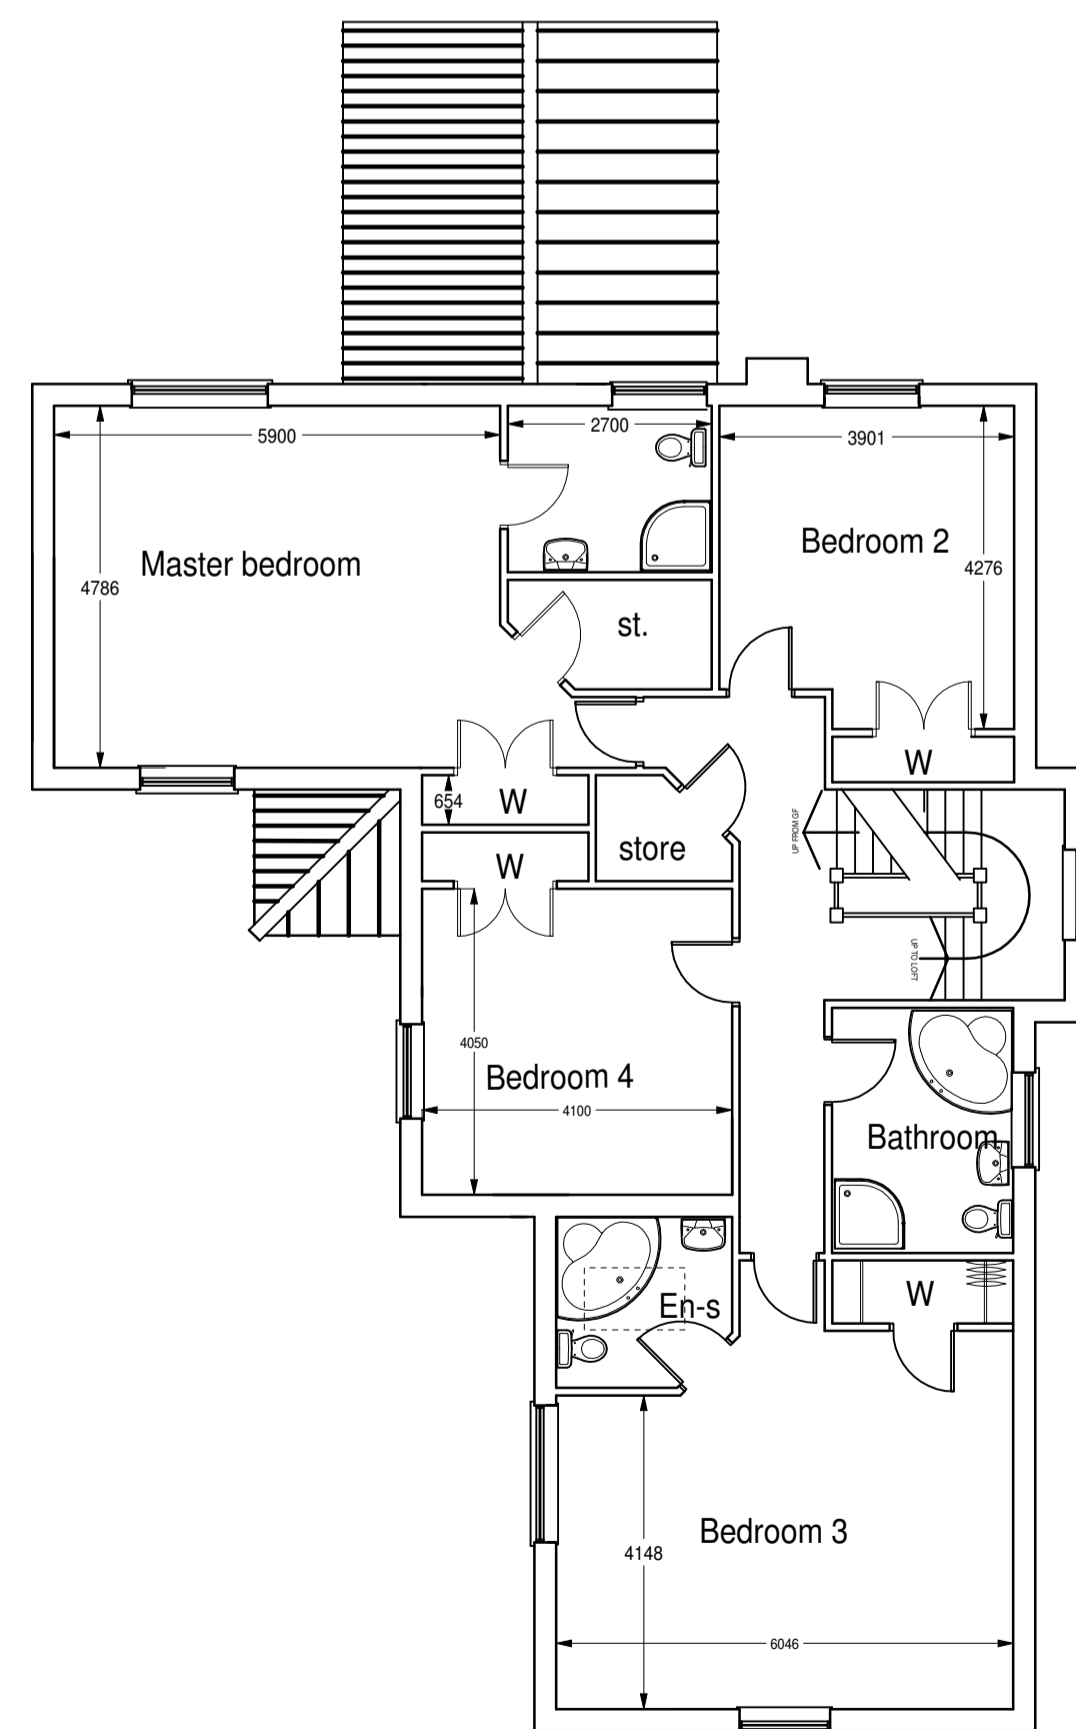

FIRST FLOOR PLAN

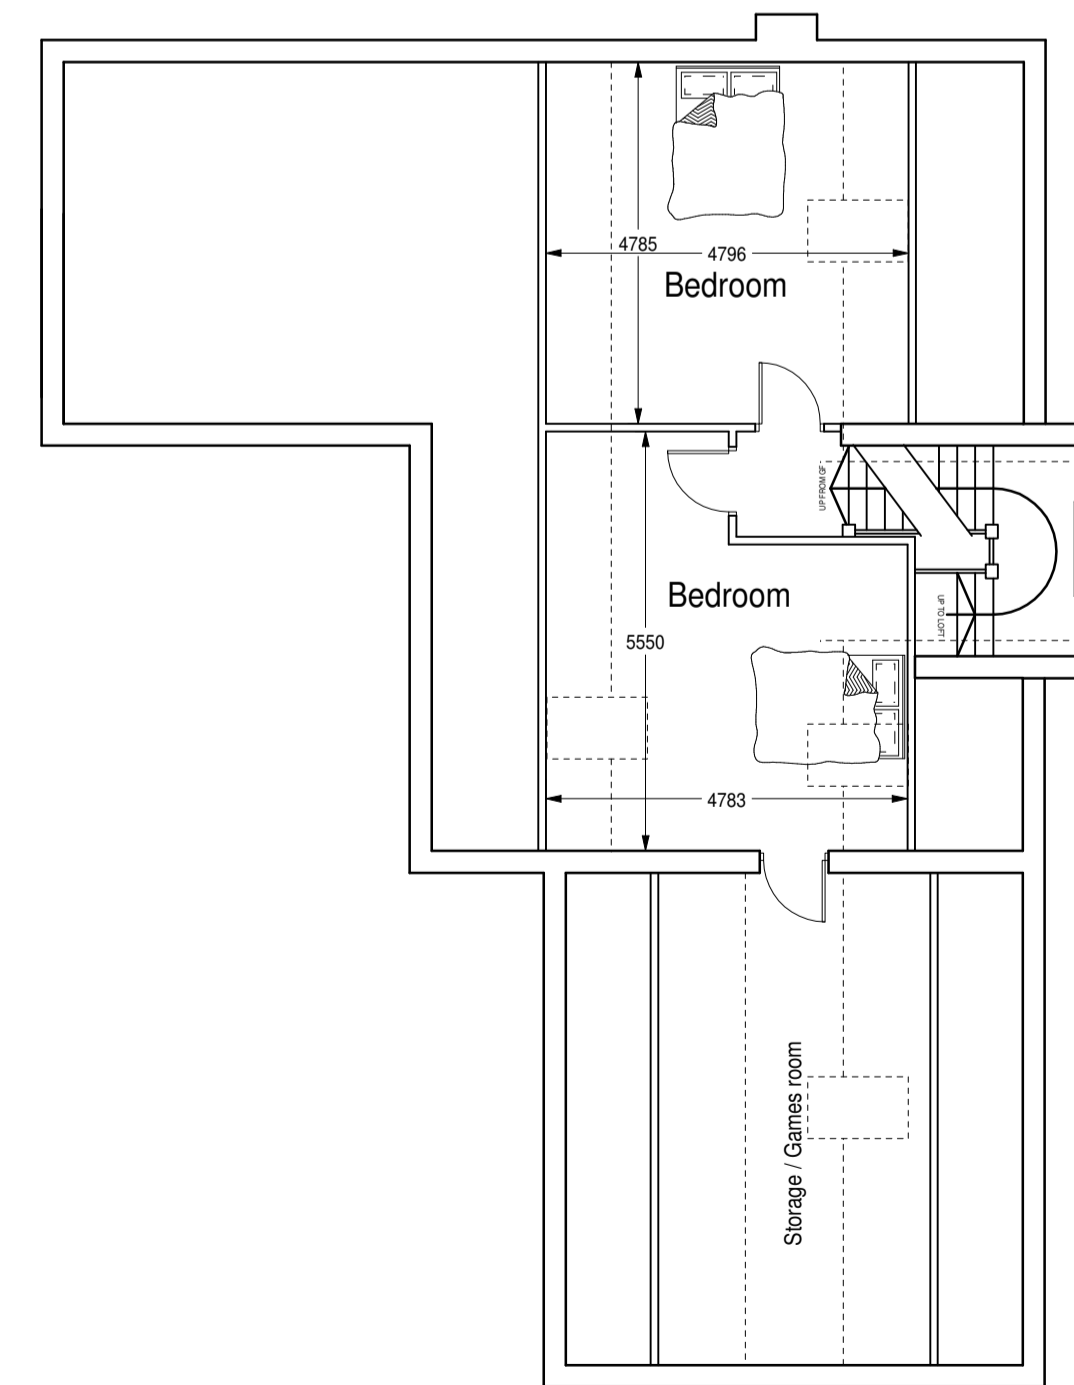

POSSIBLE LOFT CONVERSION

# Plot 3

<	<	<
A	27-07-2007	drawings amended to as built
Rev.	Date	Revision Notes

DO NOT SCALE - ALL DIMENSIONS TO BE VERIFIED ON SITE

**NICHOLSON NAIRN ARCHITECTS**
  
 Tel: 0191-4203000 Fax: 0191-4208349 Email: admin@nicholsonnairn.co.uk
   
 Bishop Court, Rectory Lane, Whickham, Newcastle upon Tyne, NE16 4PA
   
 www.nicholsonnairn.co.uk

Client		
Mr Tim Anderson		
Project		
Proposed Housing Development		
Address		
Hayworth Croft Medburn		
Scales	Date	CAD File
1:100	Apr 2006	13670-03
Drawing Title		
Proposed Floor Plans & Elevations		
Drawing No.	Rev. no.	
<b>13670-302</b>	<b>A</b>	