





EAST ELEVATION



WEST ELEVATION

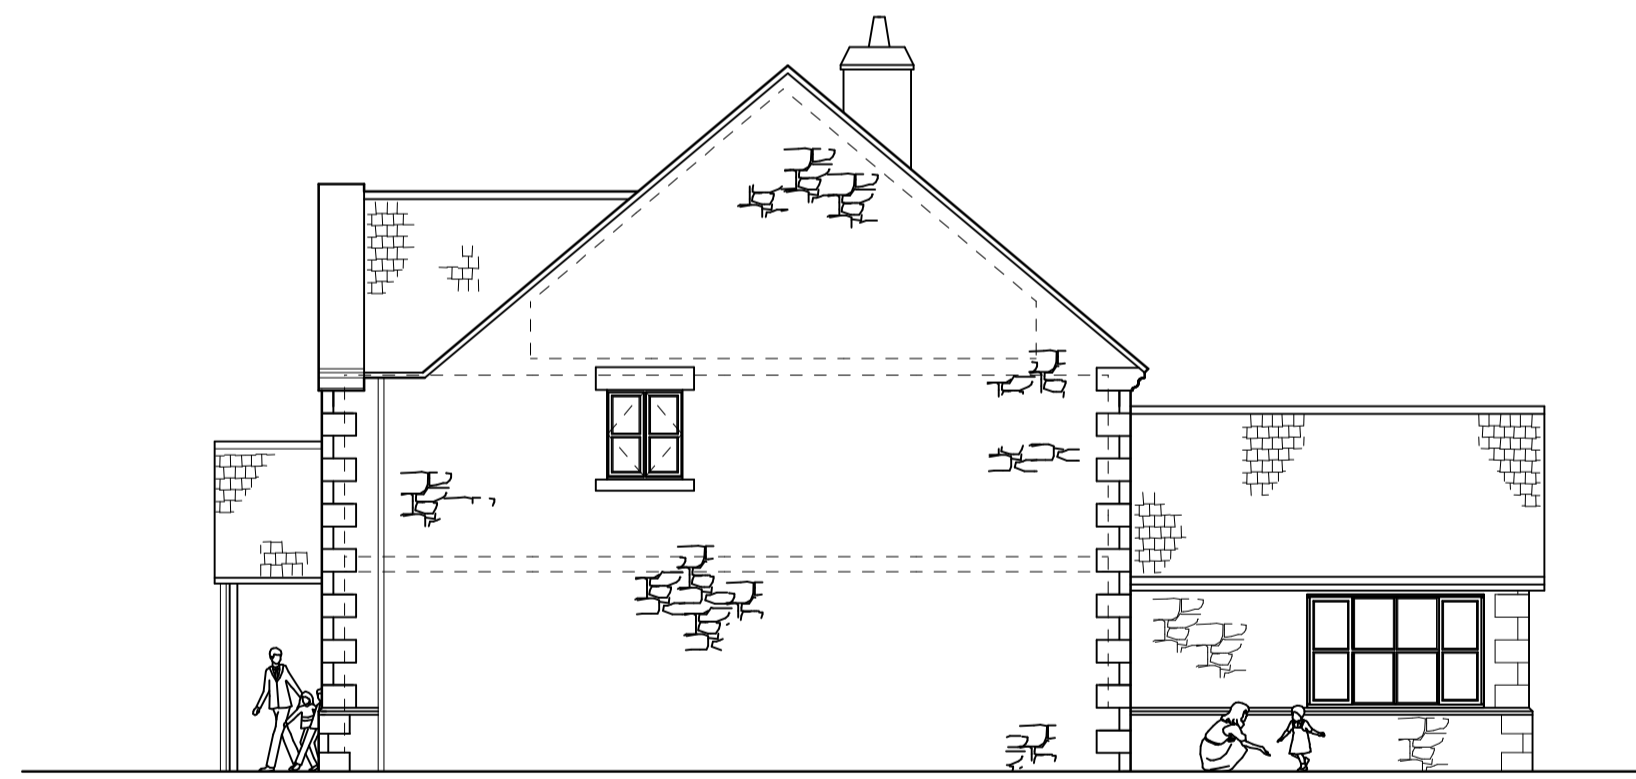

NORTH ELEVATION

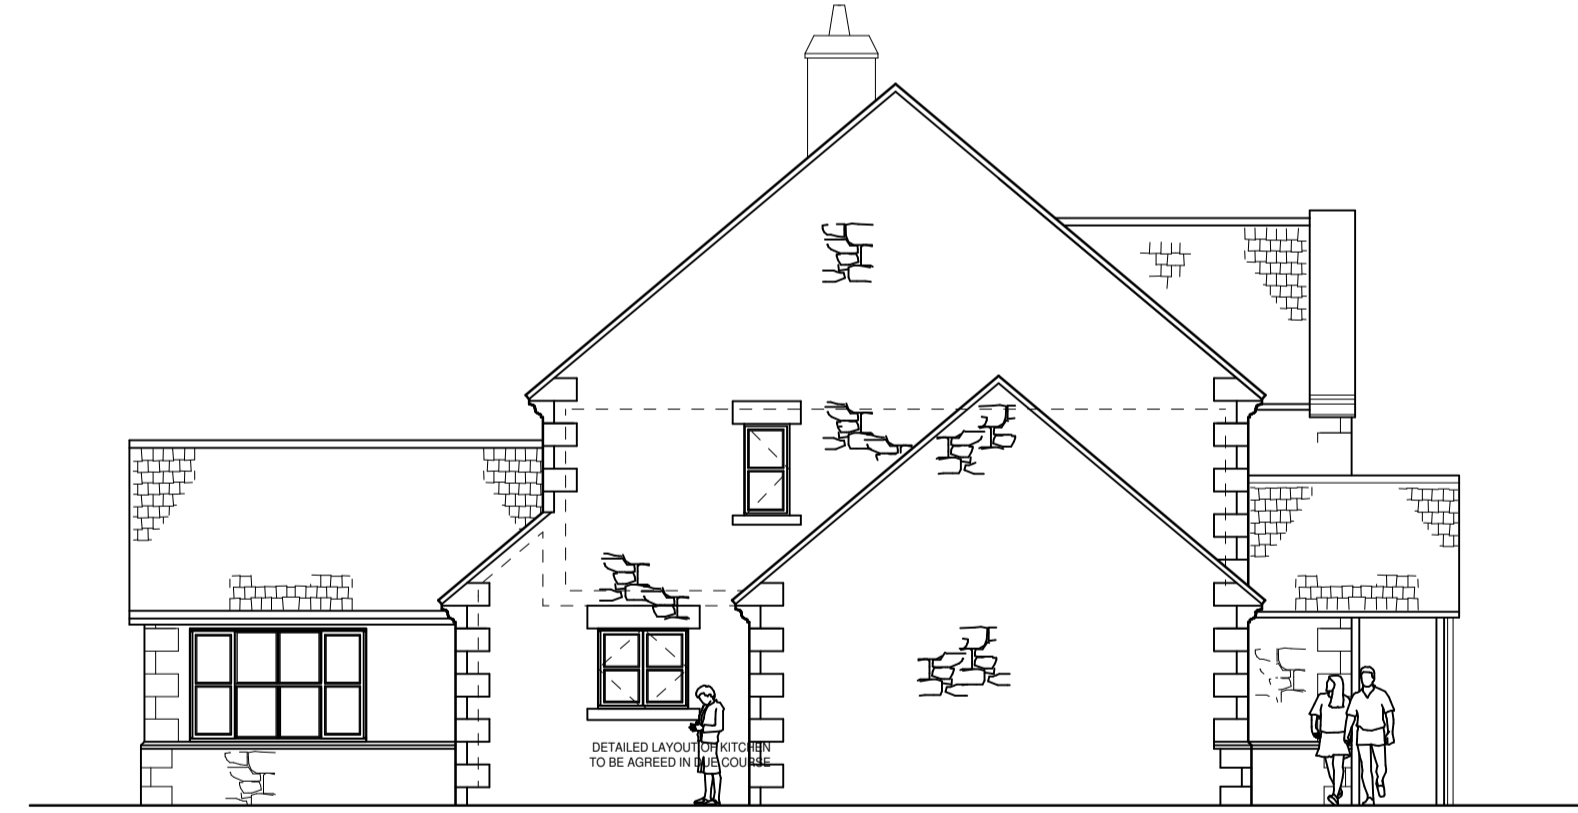

SOUTH ELEVATION

Rev.	Date	Revision Notes

DO NOT SCALE - ALL DIMENSIONS TO BE VERIFIED ON SITE

© 

Tel: 0191-4203000 Fax: 0191-4203040 Email: admin@nicholsonn.co.uk
 Bishop Court, Rectory Lane, Whickham, Newcastle upon Tyne, NE16 4PA
 www.nicholsonn.co.uk

Client Mr Tim Anderson		
Project Proposed Housing Development		
Address Hayworth Croft Medburn		
Scales 1:50	Date Feb 2008	CAD File 13670-40 plot 4 Bregs
Drawing Title Elevations As Built Drawings		
Drawing No. 13670-407	Rev. no.	