



GROUND FLOOR PLAN

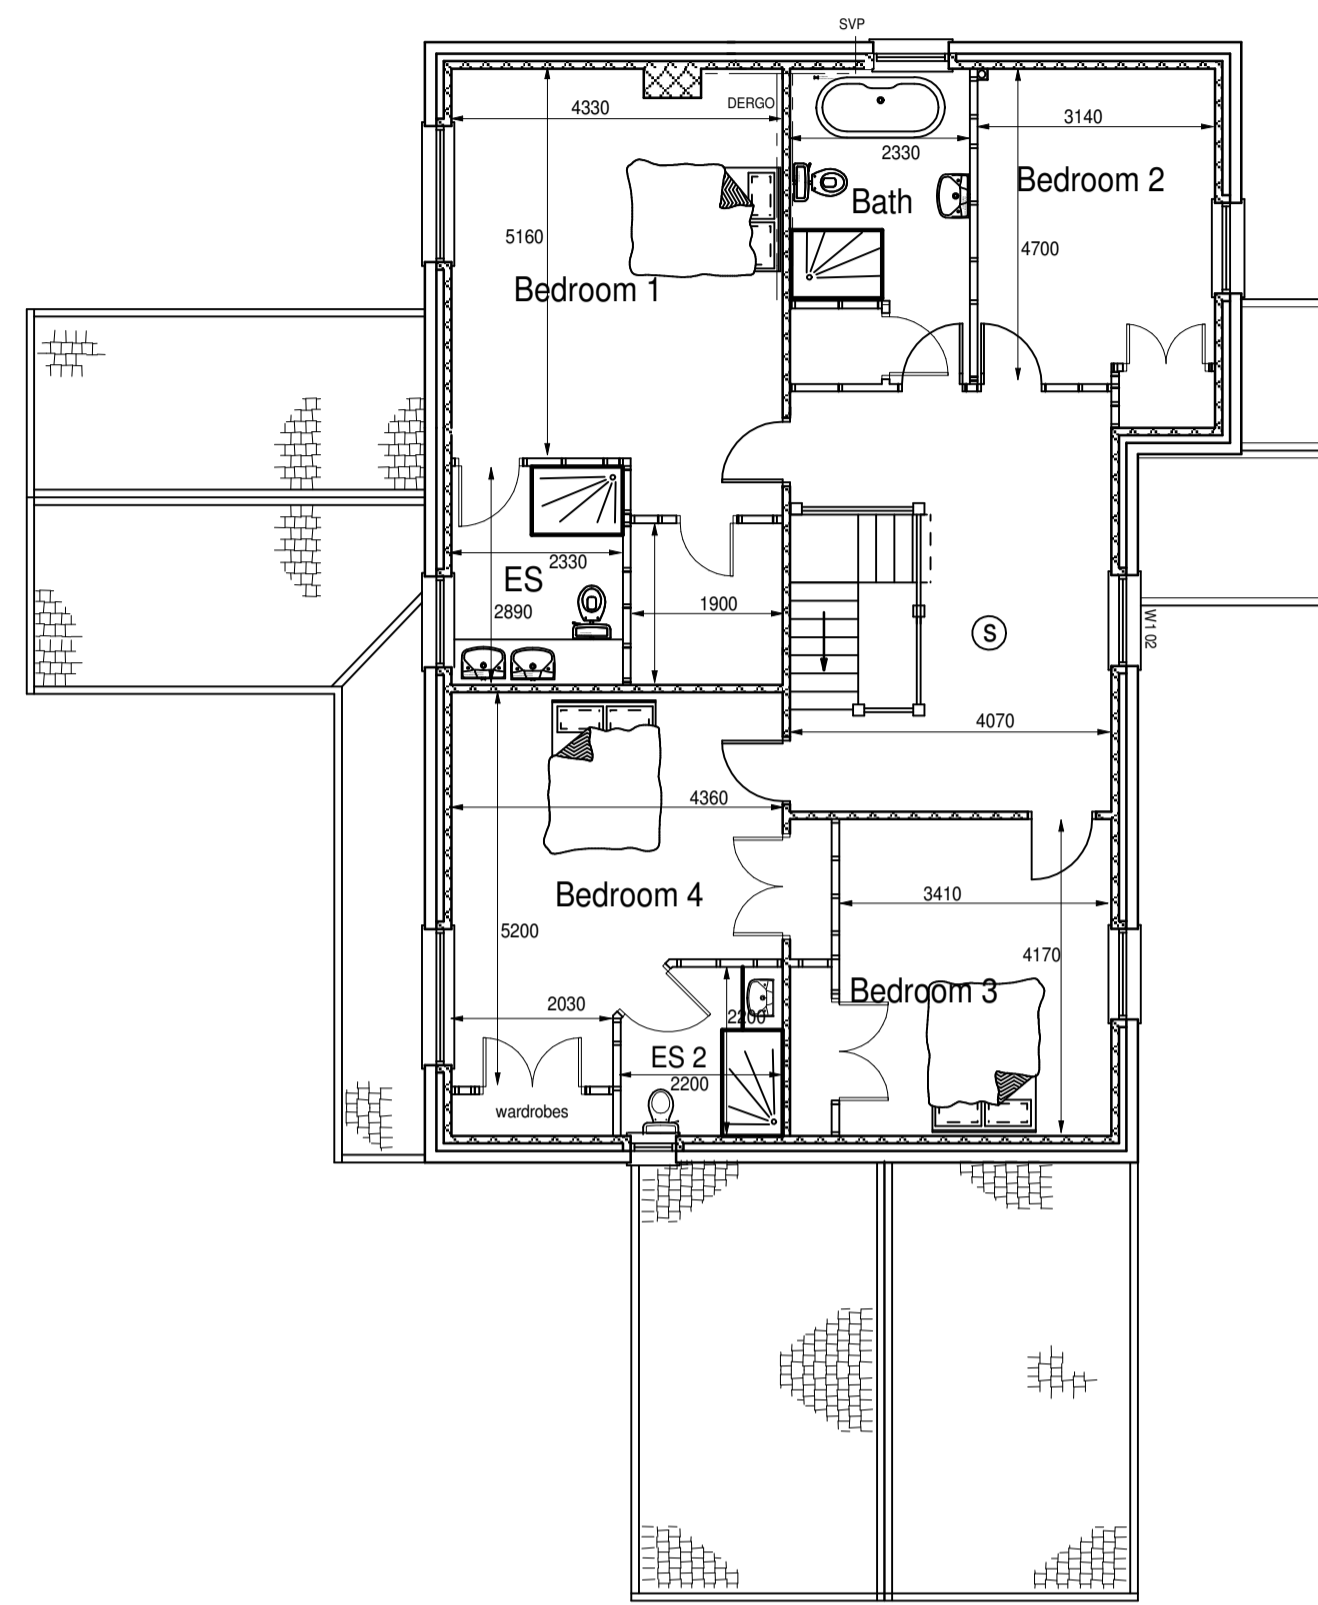


FIRST FLOOR PLAN

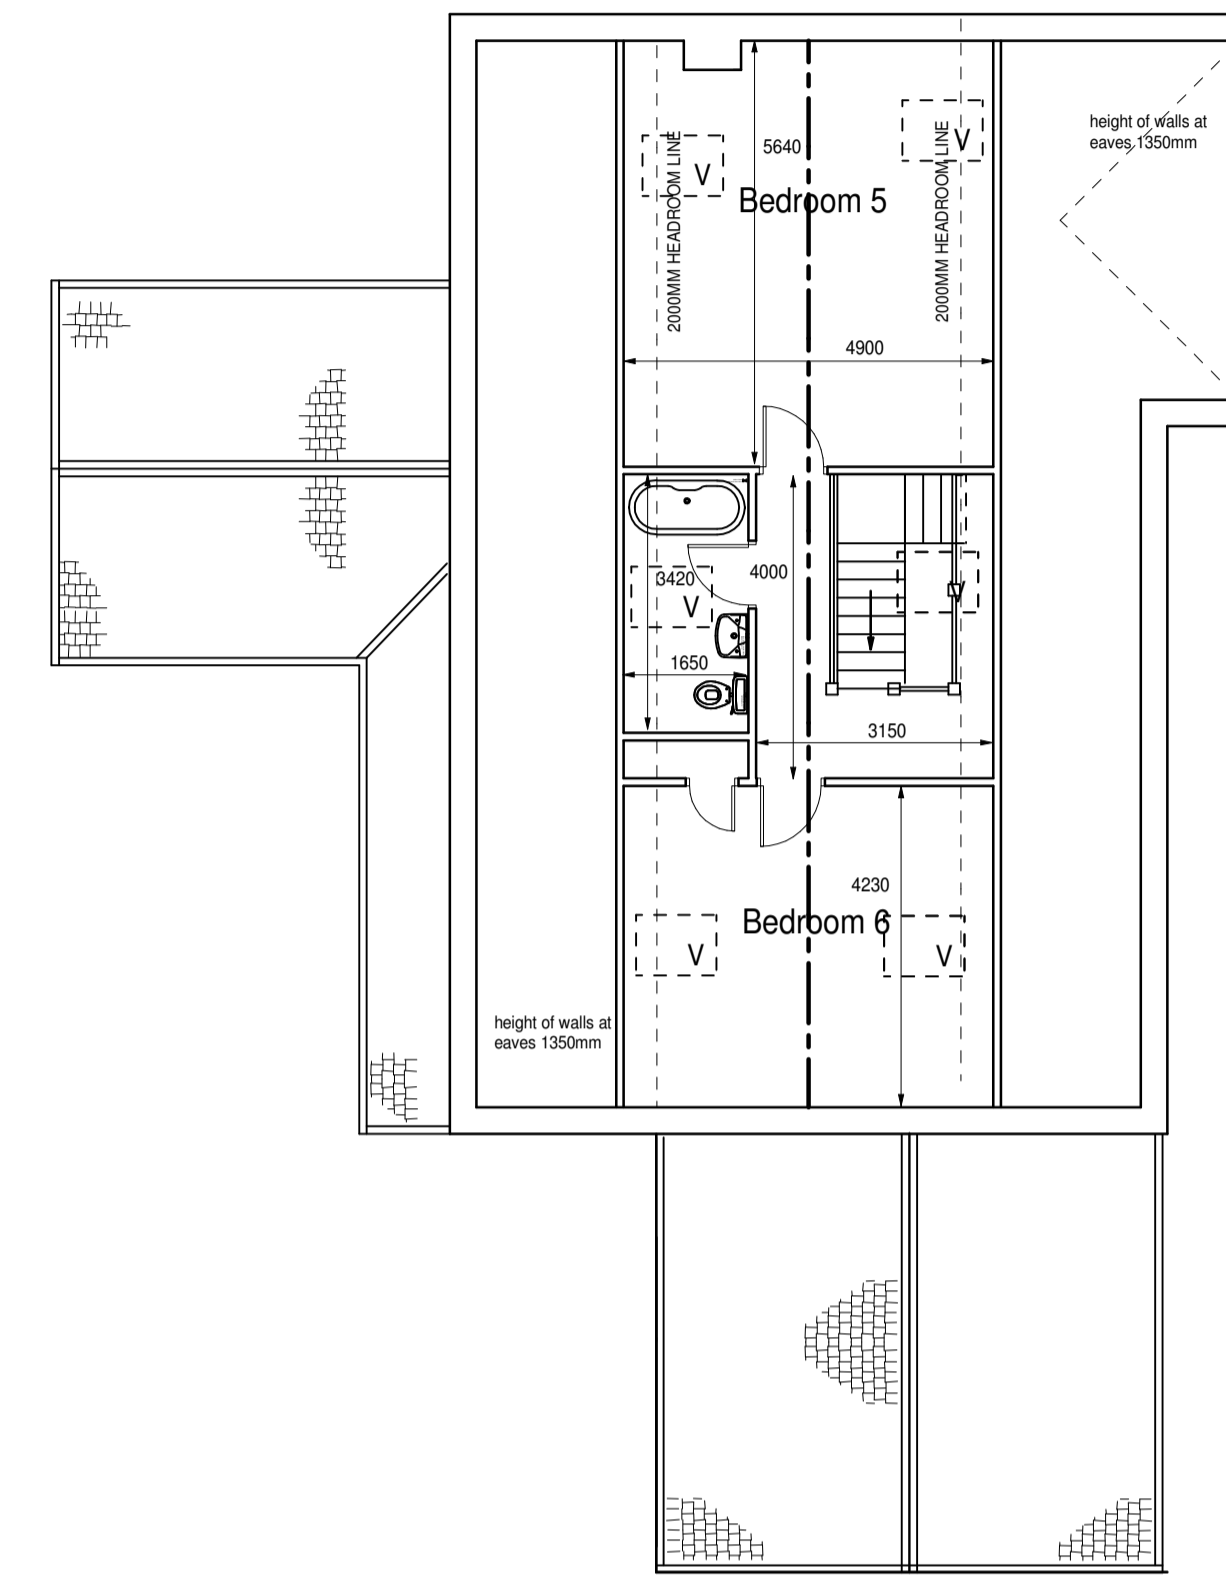

ATTIC FLOOR PLAN

# Plot 4

B		
Rev.	Date	Revision Notes
DO NOT SCALE - ALL DIMENSIONS TO BE VERIFIED ON SITE		
 <small>Tel: 0191-4203000 Fax: 0191-4203340 Email: admin@nicholsonnma.co.uk          Bishops Court, Rectory Lane, Whickham, Newcastle upon Tyne, NE16 4PA          www.nicholsonnma.co.uk</small>		
Client <b>Mr Tim Anderson</b>		
Project <b>Proposed Housing Development</b>		
Address <b>Hayworth Croft Medburn</b>		
Scales 1:50	Date Feb 2008	CAD File 13670-40 plot 4 Bregs
Drawing Title <b>PLot 4 Plans as Built</b>		
Drawing No. <b>13670-415</b>	Rev. no.	